
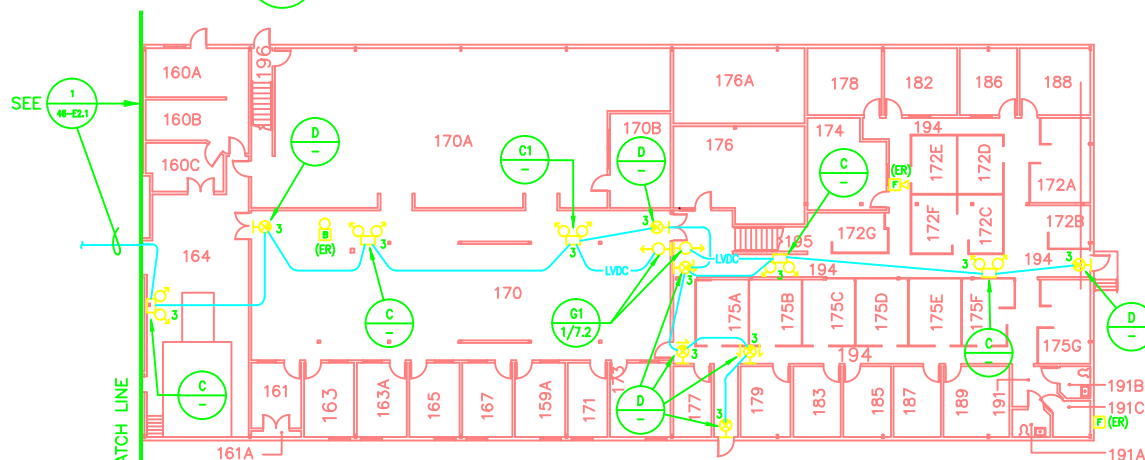



1 FIRST FLOOR DEMO. & CONSTRUCTION PLAN
46-E2.1 SCALE: 1/16"=1'-0" 



2 FIRST FLOOR DEMO. & CONSTRUCTION PLAN
46-E2.1 SCALE: 1/16"=1'-0" 

ess ARCHITECTS

466 Eighth Street
San Francisco, CA 94103
415 252-9500
415 252-1585 Fax

CONSULTANT

MAZZETTI & ASSOCIATES, INC.
Consulting Mechanical & Electrical Engineers
1000 BROADWAY STREET - SAN FRANCISCO, CA 94103-0877
TELEPHONE (415) 864-5800 FAX (415) 864-4303
621-283

REVISIONS

no.	date	description
A	90%	TITLE # 9/26/94
B	100%	TITLE # 11/7/94
C	FINAL	TITLE # 2/13/95
D	REISSUE	FINAL TITLE # 3/30/95
E	AS BUILT	7/25/97

JOB TITLE

FIRE AND SAFETY SYSTEMS UPGRADE
PHASE I
LAWRENCE BERKELEY LABORATORY, UNIVERSITY OF CALIFORNIA
BERKELEY, CALIFORNIA

KEY PLAN



ESS ARCHITECTS JOB #: 9292

LBL SC#: 728

LBL FILE DRAWING: *

ACAD FILE NAME:

LBNL
DWG. 3N46E056E
PROJ # 120257

SHEET TITLE:
BUILDING 46
FIRST FLOOR
DEMO. & CONSTRUCTION PLAN

SCALE: AS NOTED	DATE: 2/13/95
-----------------	---------------

SCALE: AS NOTED	DATE: 2/15/93
DRAWN BY: XXXXXXXXXX	

SHEET: 46-E2.1E 